






25937

OK

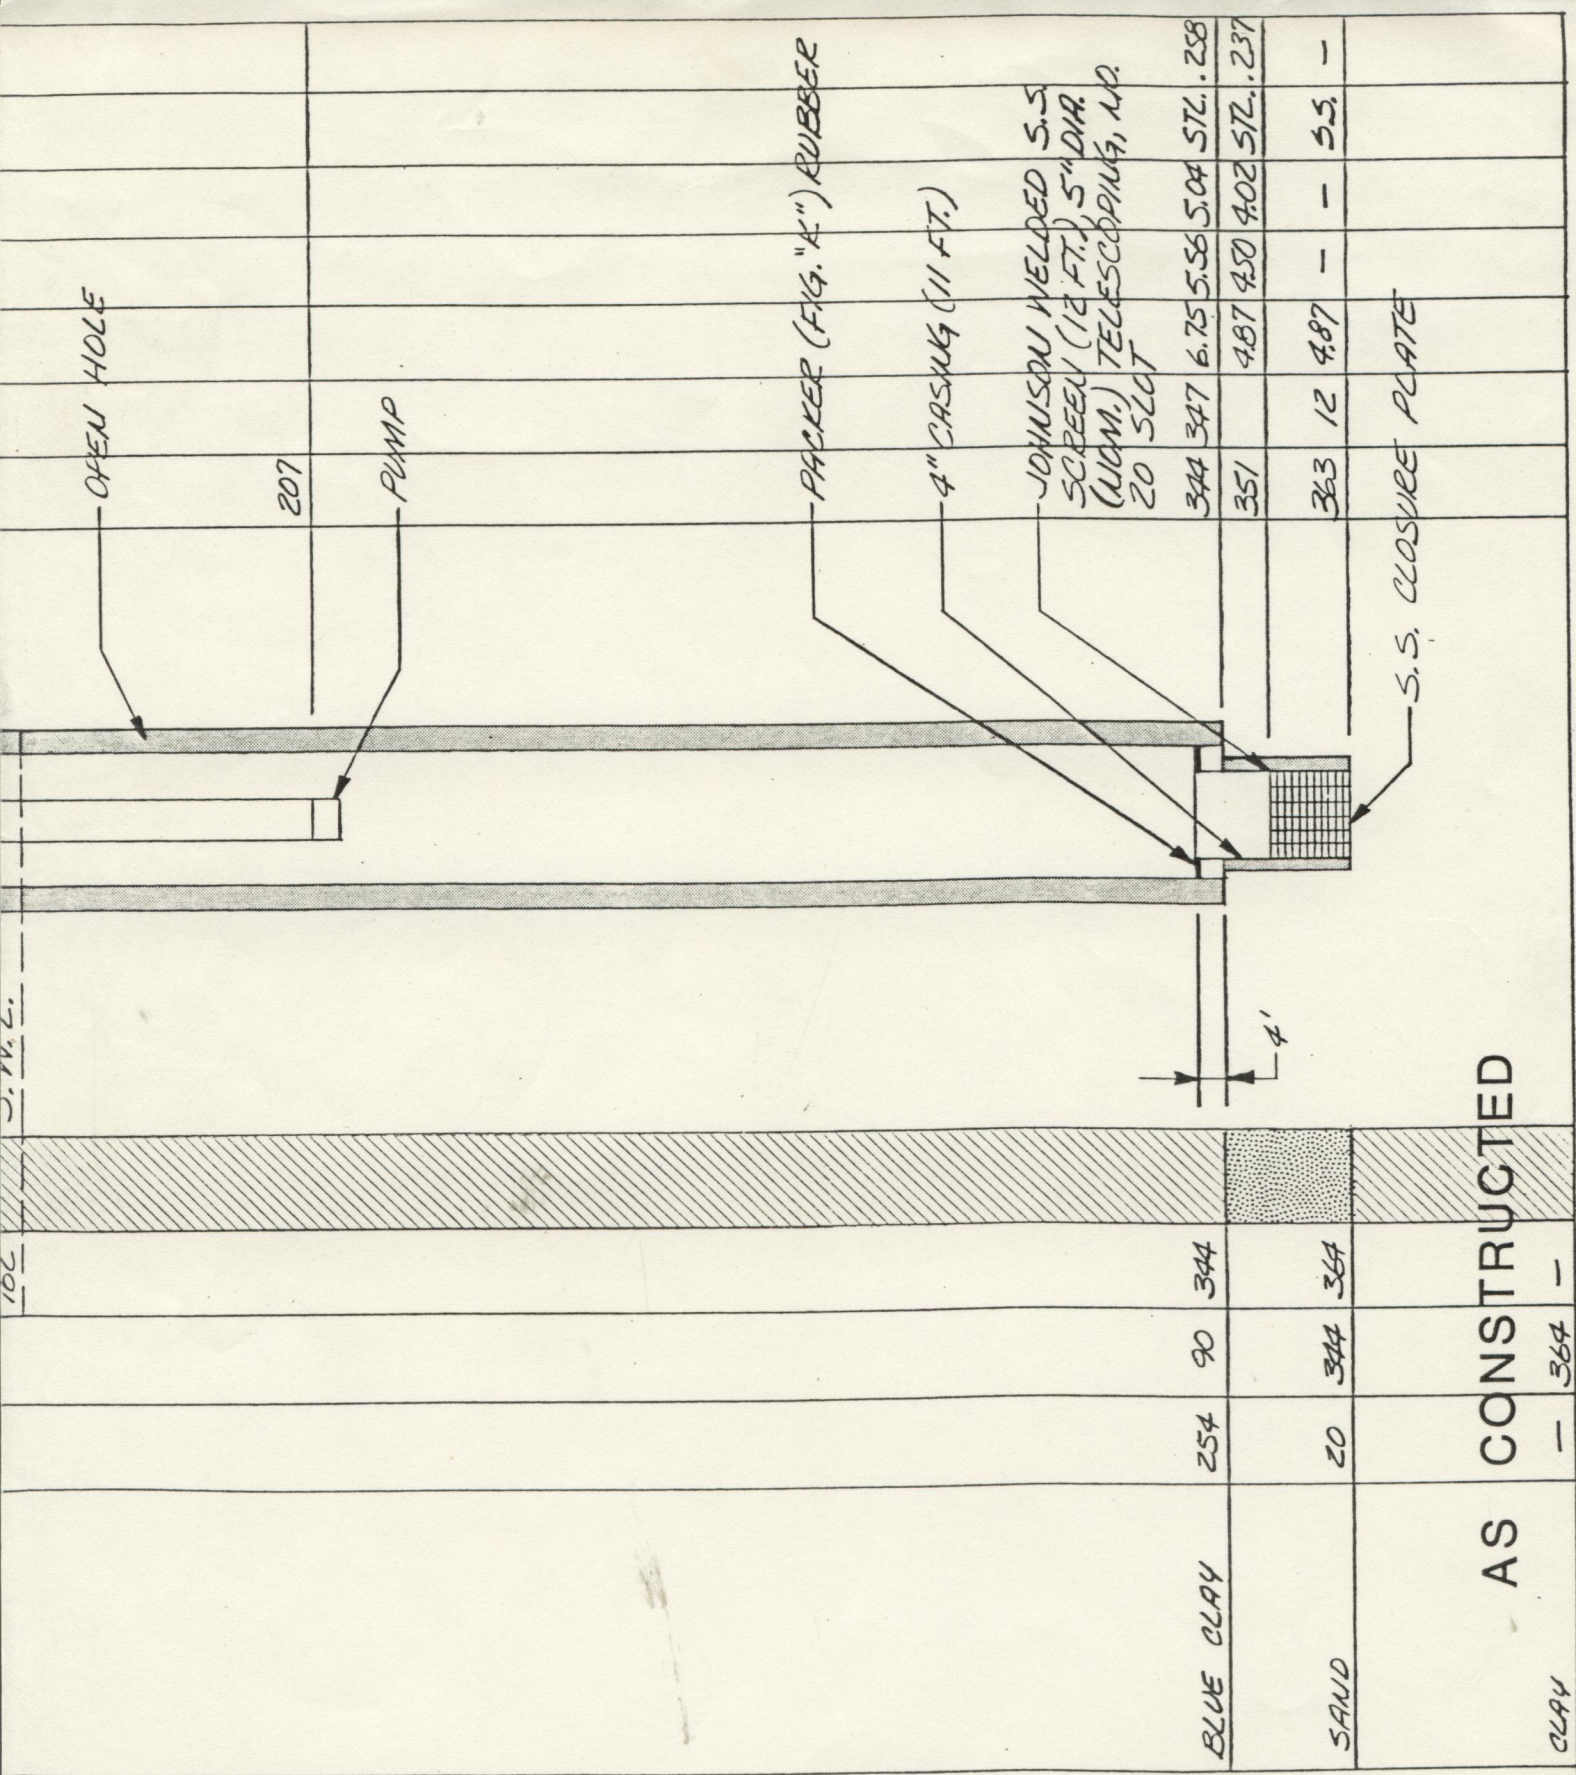

344	347	6.75	5.56	5.04	57L. 288
351		4.87	4.50	4.02	57L. 237
363	12	4.87	-	-	5.5 -

AS CONSTRUCTED

CLAY

- 364 -

344

90

254

20

344

364

-